




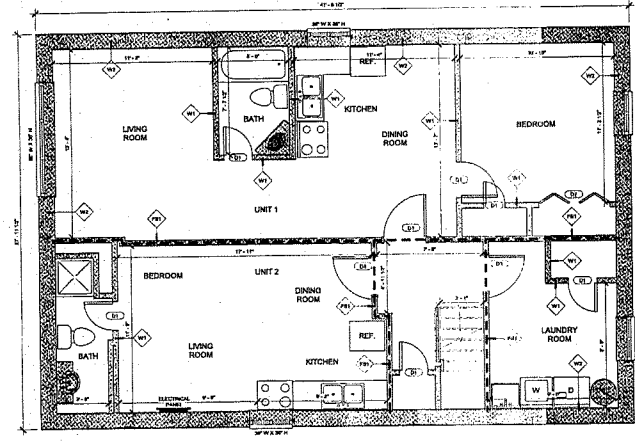


1. BASEMENT PLAN
1/4" = 1'-0"

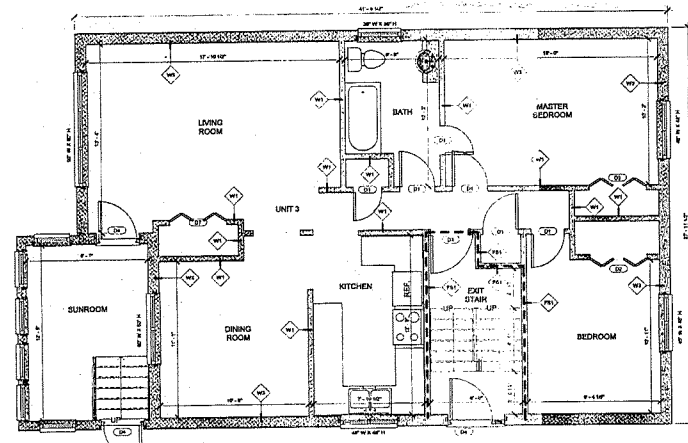


2. FIRST FLOOR PLAN
1/4" = 1'-0"

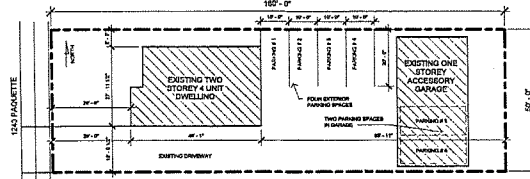

4. PLOT PLAN
1" = 20'-0"

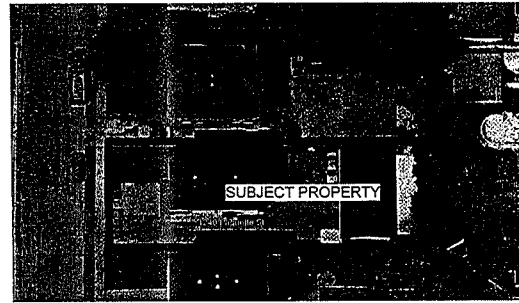


3. SECOND FLOOR PLAN
1/4" = 1'-0"

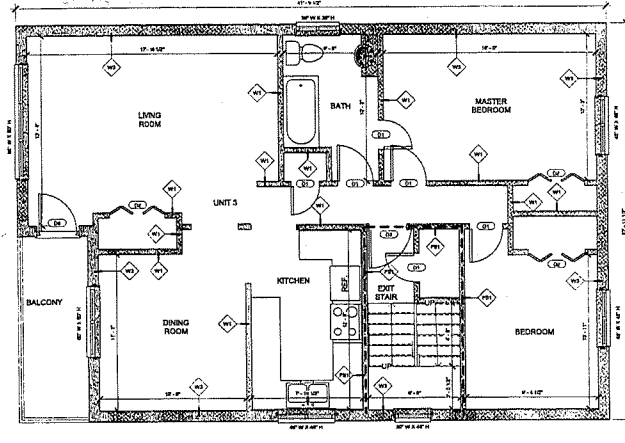

Ontario Building Code Data Sheet - Part 11 - Renovation of Existing Building			600
11.1	Existing Building Description:	Grade (G) (Qualify Item):	11.1.1
	Commercial: ☒ Industrial: ☐ Residential: ☐ Other: ☐	Grade: ☐ Qualify Item: ☐	11.1.1.1
	Not Applicable (no change of major occupancy)		11.1.1.2
11.2	Alteration in Existing Building:	Grade (G) (Qualify Item):	11.2.1
	Structural: ☐ Mechanical: ☐ Electrical: ☐ Other: ☐	Grade: ☐ Qualify Item: ☐	11.2.1.1
11.3	Reduction in Performance Level:	Grade (G) (Qualify Item):	11.3.1
	Structural: ☐ Mechanical: ☐ Electrical: ☐ Other: ☐	Grade: ☐ Qualify Item: ☐	11.3.1.1
11.4	Compensating Construction:	Grade (G) (Qualify Item):	11.4.1
	Structural: ☐ Mechanical: ☐ Electrical: ☐ Other: ☐	Grade: ☐ Qualify Item: ☐	11.4.1.1

11.5	Change of major occupancy:	Grade (G) (Qualify Item):	11.5.1
	No change in major occupancy: ☒ Yes (qualify): ☐	Grade: ☐ Qualify Item: ☐	11.5.1.1
11.6	Penetration:	Grade (G) (Qualify Item):	11.6.1
	No penetration work proposed or required: ☒ Yes (qualify): ☐	Grade: ☐ Qualify Item: ☐	11.6.1.1
11.7	Seismic System:	Grade (G) (Qualify Item):	11.7.1
	Seismic System: ☒ Yes (qualify): ☐	Grade: ☐ Qualify Item: ☐	11.7.1.1
11.8	Conformance with Code:	Grade (G) (Qualify Item):	11.8.1
	Conformance with Code: ☒ Yes (qualify): ☐	Grade: ☐ Qualify Item: ☐	11.8.1.1
11.9	Alternative Materials:	Grade (G) (Qualify Item):	11.9.1
	Alternative Materials: ☐ Yes (qualify): ☐	Grade: ☐ Qualify Item: ☐	11.9.1.1

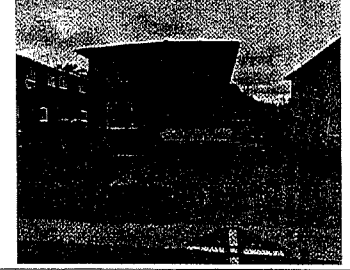

THESE DRAWINGS AND THE DESIGN CONTAINED ON THEM ARE THE PROPERTY OF NORTH SOUTH STUDIO. NO PART OF THESE DRAWINGS OR DESIGN MAY BE REPRODUCED OR TRANSMITTED IN ANY FORM OR BY ANY MEANS, ELECTRONIC OR MECHANICAL, INCLUDING PHOTOCOPYING, RECORDING, OR BY ANY INFORMATION STORAGE AND RETRIEVAL SYSTEM, WITHOUT THE WRITTEN PERMISSION OF NORTH SOUTH STUDIO.

REVISIONS

NO.	DESCRIPTION
1	
2	
3	
4	
5	
6	

NORTH SOUTH STUDIO
218 DECORE ROAD
ST. CHARLES, ONTARIO
P0M 2V0
PHONE: (709) 618-7727
E-MAIL: nssdesign@nssstudio.ca
WEBSITE: www.northsouthstudio.online

PROJECT
AS-BUILT DRAWINGS FOR
1240 PAQUETTE STREET, SUDBURY
ON THIS SHEET
PLANS, CODE REVIEW & PLOT PLAN

DRAWN
AM
CHECKED
AM
DATE
05/01/19
SCALE
As Indicated

North South Studio
YOUR HOME IS OUR PASSION

WWW.NORTHSOUTHSTUDIO.ONLINE

A1